



CONTROL PANEL EAST SIDE



CONTROL PANEL WEST SIDE

REFURBISH ELECTRIC PANELS TO ACHIEVE WATERTIGHT CONDITION AND MAKE PROVISIONS FOR A HEAVY DUTY PROTECTIVE ENCLOSURE BOLTED TO CONCRETE SLAB. **(PENDING)**




VIEW NORTHEAST



VIEW WEST



VIEW EAST

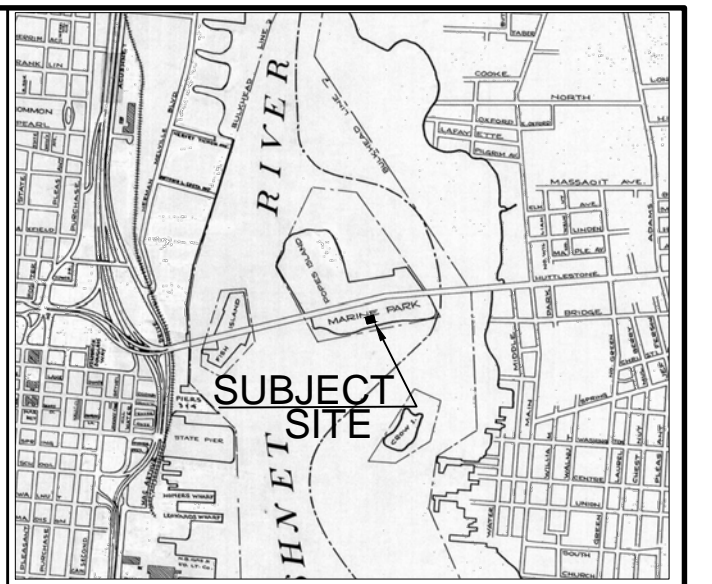

LOCUS PLAN N.T.S.
Popes Island Pump Station

BENCHMARK ON HATCH FLANGE AT SE CRNR ELEVATION 5.61

GENERAL NOTES FOR AS-BUILT:

- FLOOD PROTECTION ELEVATION:
 Inundation w/ 0' Sea Level Rise ELEVATION 0.00
 Inundation w/ 1' Sea Level Rise ELEVATION 1.42
 Inundation w/ 2' Sea Level Rise ELEVATION 14.10
 Inundation w/ 4' Sea Level Rise ELEVATION 16.69

FLOOD PROTECTION LEVEL:

1. IN ANTICIPATION OF A SEVERE STORM OR HURRICANE EVENT WHERE IT IS EXPECTED THAT THE POPES ISLAND PUMP STATION WILL BE DAMAGED, THE CITY IS ABLE TO TAKE THE STATION OUT OF SERVICE FOR THE STORM PERIOD. AFTER THE STORM THE CONTROLS WILL BE EVALUATED AND IF IT IS NECESSARY TO REPLACE THE CONTROLS THE CITY CAN MAINTAIN THE PUMP STATION SERVICE WITH OUR OTHER RESOURCES UNTIL THE CONTROLS HAVE BEEN REPLACED.

**AS-BUILT
SEPTEMBER 27, 2016**

NO.	DATE	DESCRIPTION	BY
1	9/27/16	CONVERT DRAWING TO AS-BUILT	DJF

CITY OF NEW BEDFORD
DEPARTMENT OF PUBLIC INFRASTRUCTURE
Popes Island Pump Station Map 60 Lot 2
86 Popes Island @ Marina New Bedford MA 02740
DESIGNED BY : DJF
CHECKED BY :
SCALE: NTS
DATE : April 8, 2016
SHEET 9